



QUAIL CIRCLE 60 FT. WD. PLAN

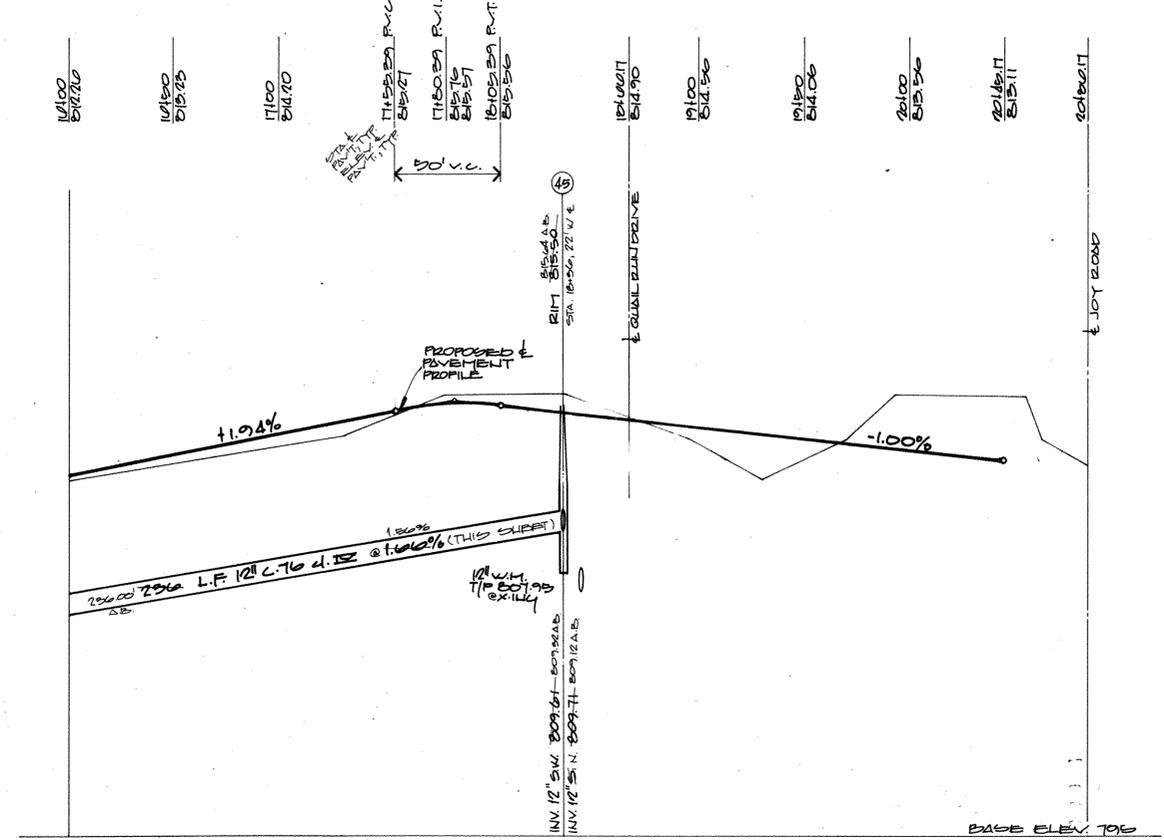


PROFILE

JOY ROAD 93 FT. WD.

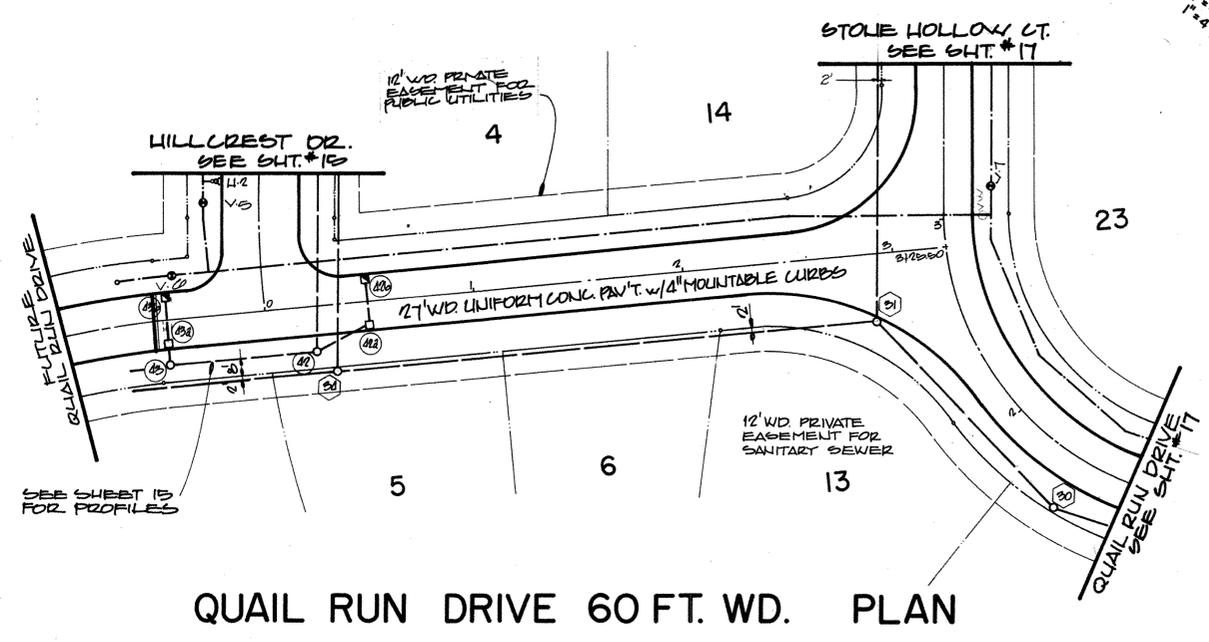

QUAIL RUN DRIVE 60 FT. WD. PLAN

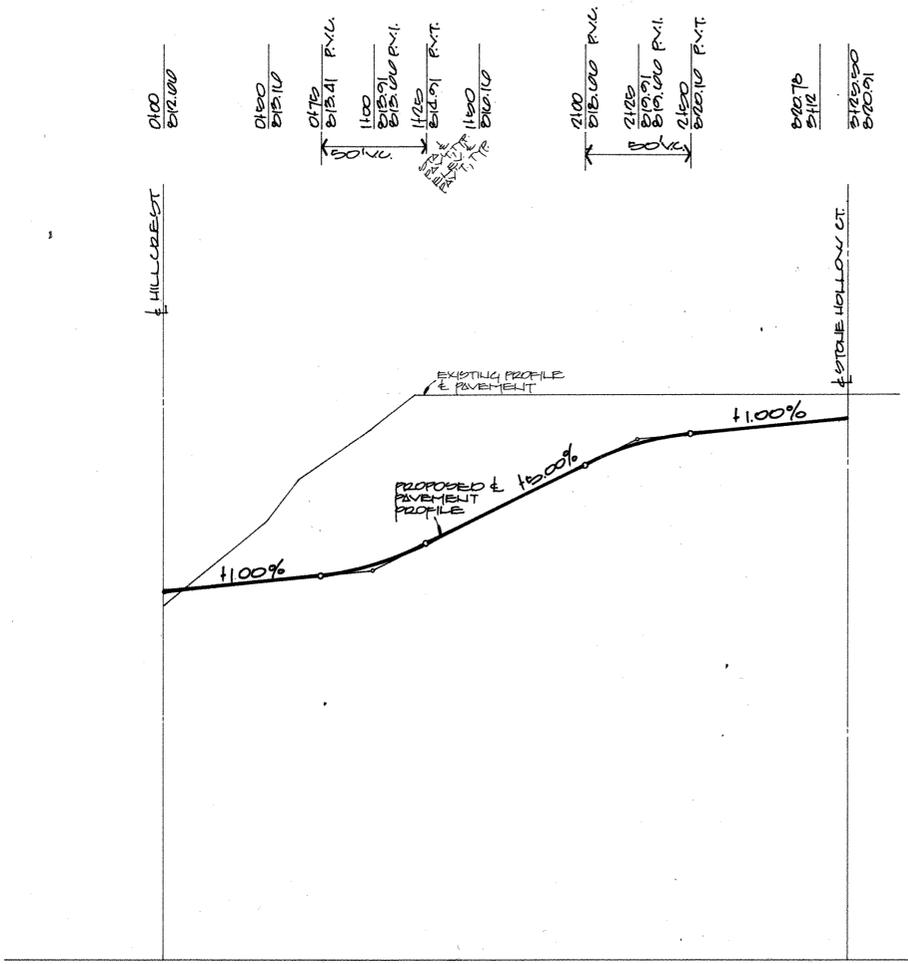

PROFILE

NOTE: The as-built sections of these plans bear the designation "A.B." for as-built.  
 QUAIL RUN DRIVE  
 QUAIL CIRCLE

**JMS** Jarrett - Mills - Schron and associates, inc.  
 CONSULTING ENGINEERS  
 P.O. Box 400, 31222 Midland Ave., Westland, Michigan 48186  
 (313) 722-8500

**STORM SEWER PLAN & PROFILE**

**QUAIL RUN SUBDIVISION**  
 PART OF THE S.W. 1/4 SEC. 32, T.15 S., R.9 E.,  
 PLYMOUTH TWP., WAYNE CO., MICHIGAN

REVISIONS	DATE	DRAWING NO.	JOB NO.	SHEET NO.
1	9-25-80	A-448	B-00120	10
2	10-15-80			
3	11-15-80			
4	12-15-80			

DRAWN BY: [Signature]  
 CHECKED BY: [Signature]