



REAR LOT LINE PLAN

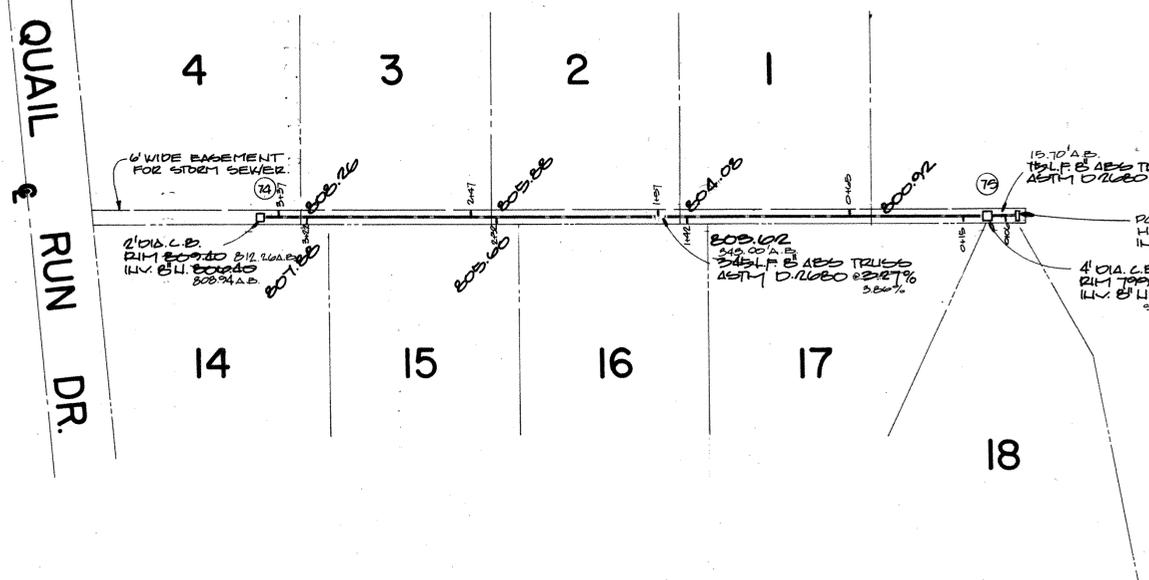

REAR LOT LINE PLAN

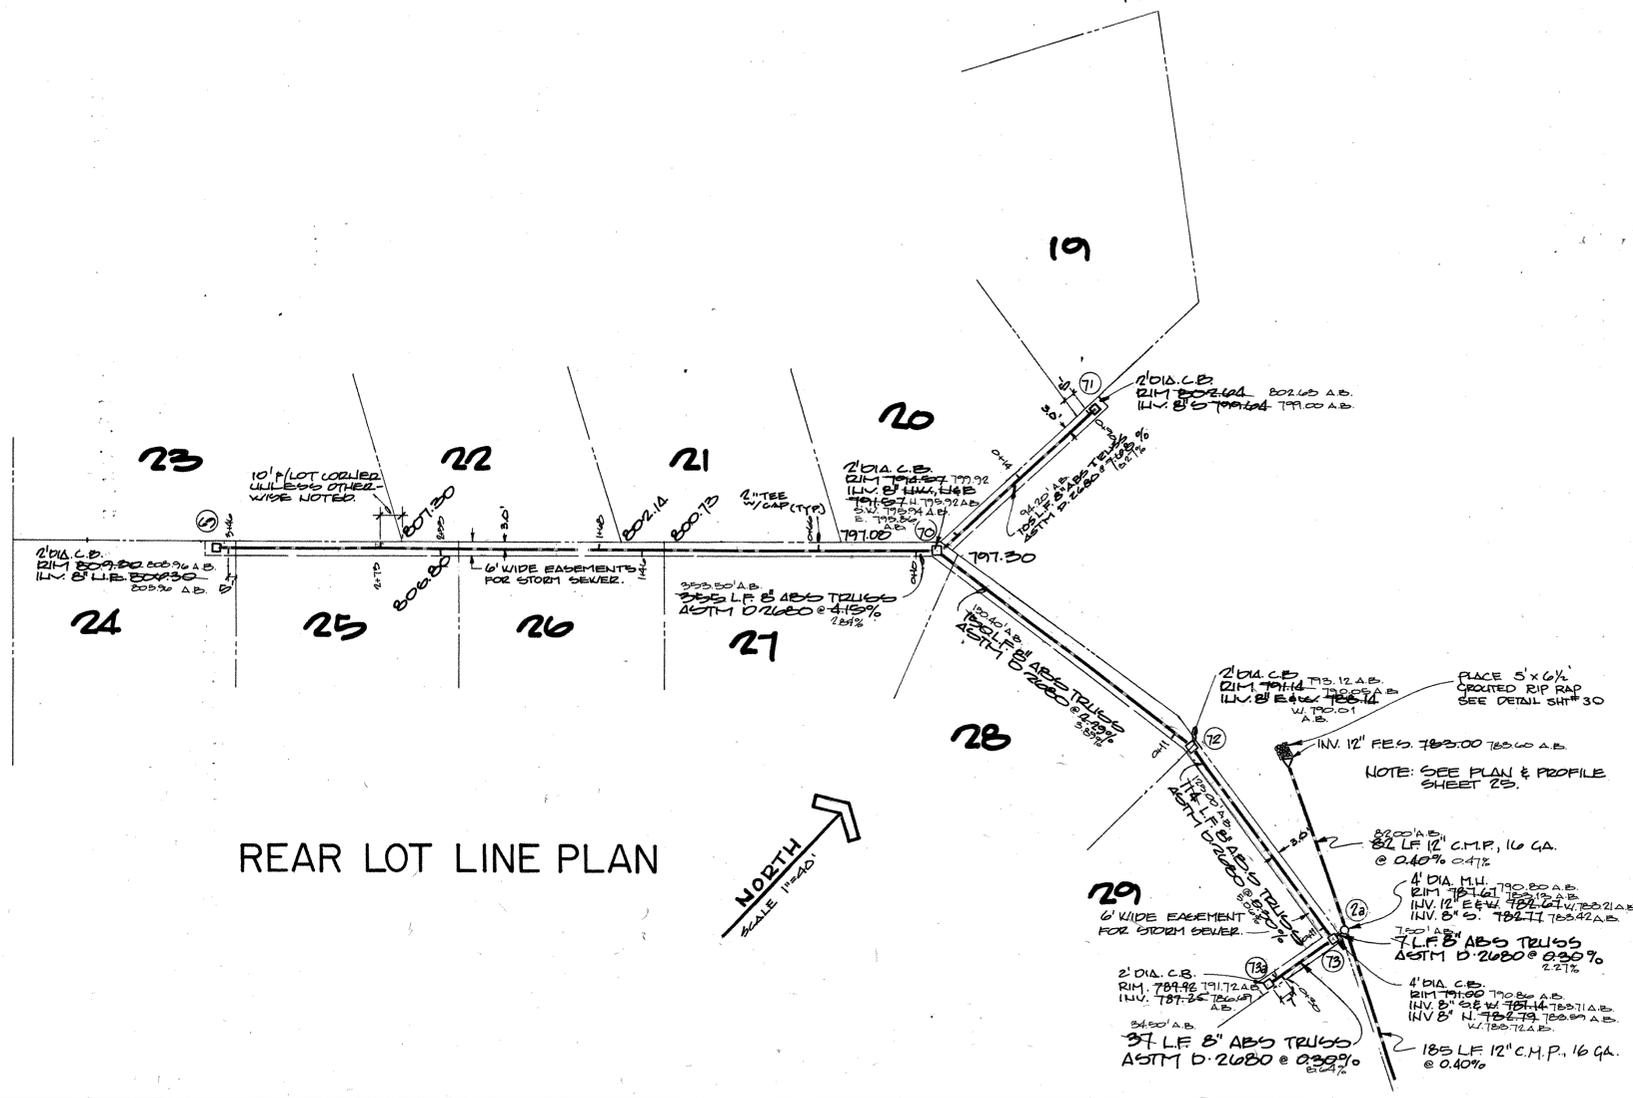

REAR LOT LINE PLAN

NOTE: The as-built sections of these plans bear the designation "A.B." for as-built.

ALL 12" C-76 CL. IV CATCH BASIN LEADS TO BE TRENCH "A" REGARDLESS OF LOCATION.

ALL SMALL DIAMETER PIPE CONNECTIONS TO THE MAINLINE SEWER SHALL BE TRENCH "A".

BACKFILL AROUND ALL MANHOLES WITH POROUS BACKFILL GRADE "D". (COST INCIDENTAL TO MANHOLE INSTALLATION)

**JMS**

**Jarrett - Mills - Schron and Associates, Inc.**  
CONSULTING ENGINEERS AND LAND SURVEYORS  
P.O. Box 406, 3122 Michigan Ave., Westland, Michigan 48090  
(313) 722-5800

**QUAIL RUN SUBDIVISION**  
PART of the SW 1/4 SEC. 32, T. 15S, R. 8E., PLYMOUTH TWP., WAYNE CO., MICH.

SHEET NO.	JOB NO.	DRAWING NO.	DATE	REVISIONS	REAR YARD STORM LAYOUT
27	860420	A-459	9-25-86	1/25/86 2/16/86 3/10/86 4/14/86 5/12/86 6/10/86 7/14/86 8/11/86 9/15/86 10/13/86 11/10/86 12/8/86 1/5/87 2/2/87 3/1/87 4/1/87 5/1/87 6/1/87 7/1/87 8/1/87 9/1/87 10/1/87 11/1/87 12/1/87 1/1/88 2/1/88 3/1/88 4/1/88 5/1/88 6/1/88 7/1/88 8/1/88 9/1/88 10/1/88 11/1/88 12/1/88 1/1/89 2/1/89 3/1/89 4/1/89 5/1/89 6/1/89 7/1/89 8/1/89 9/1/89 10/1/89 11/1/89 12/1/89 1/1/90 2/1/90 3/1/90 4/1/90 5/1/90 6/1/90 7/1/90 8/1/90 9/1/90 10/1/90 11/1/90 12/1/90 1/1/91 2/1/91 3/1/91 4/1/91 5/1/91 6/1/91 7/1/91 8/1/91 9/1/91 10/1/91 11/1/91 12/1/91 1/1/92 2/1/92 3/1/92 4/1/92 5/1/92 6/1/92 7/1/92 8/1/92 9/1/92 10/1/92 11/1/92 12/1/92 1/1/93 2/1/93 3/1/93 4/1/93 5/1/93 6/1/93 7/1/93 8/1/93 9/1/93 10/1/93 11/1/93 12/1/93 1/1/94 2/1/94 3/1/94 4/1/94 5/1/94 6/1/94 7/1/94 8/1/94 9/1/94 10/1/94 11/1/94 12/1/94 1/1/95 2/1/95 3/1/95 4/1/95 5/1/95 6/1/95 7/1/95 8/1/95 9/1/95 10/1/95 11/1/95 12/1/95 1/1/96 2/1/96 3/1/96 4/1/96 5/1/96 6/1/96 7/1/96 8/1/96 9/1/96 10/1/96 11/1/96 12/1/96 1/1/97 2/1/97 3/1/97 4/1/97 5/1/97 6/1/97 7/1/97 8/1/97 9/1/97 10/1/97 11/1/97 12/1/97 1/1/98 2/1/98 3/1/98 4/1/98 5/1/98 6/1/98 7/1/98 8/1/98 9/1/98 10/1/98 11/1/98 12/1/98 1/1/99 2/1/99 3/1/99 4/1/99 5/1/99 6/1/99 7/1/99 8/1/99 9/1/99 10/1/99 11/1/99 12/1/99 1/1/00 2/1/00 3/1/00 4/1/00 5/1/00 6/1/00 7/1/00 8/1/00 9/1/00 10/1/00 11/1/00 12/1/00 1/1/01 2/1/01 3/1/01 4/1/01 5/1/01 6/1/01 7/1/01 8/1/01 9/1/01 10/1/01 11/1/01 12/1/01 1/1/02 2/1/02 3/1/02 4/1/02 5/1/02 6/1/02 7/1/02 8/1/02 9/1/02 10/1/02 11/1/02 12/1/02 1/1/03 2/1/03 3/1/03 4/1/03 5/1/03 6/1/03 7/1/03 8/1/03 9/1/03 10/1/03 11/1/03 12/1/03 1/1/04 2/1/04 3/1/04 4/1/04 5/1/04 6/1/04 7/1/04 8/1/04 9/1/04 10/1/04 11/1/04 12/1/04 1/1/05 2/1/05 3/1/05 4/1/05 5/1/05 6/1/05 7/1/05 8/1/05 9/1/05 10/1/05 11/1/05 12/1/05 1/1/06 2/1/06 3/1/06 4/1/06 5/1/06 6/1/06 7/1/06 8/1/06 9/1/06 10/1/06 11/1/06 12/1/06 1/1/07 2/1/07 3/1/07 4/1/07 5/1/07 6/1/07 7/1/07 8/1/07 9/1/07 10/1/07 11/1/07 12/1/07 1/1/08 2/1/08 3/1/08 4/1/08 5/1/08 6/1/08 7/1/08 8/1/08 9/1/08 10/1/08 11/1/08 12/1/08 1/1/09 2/1/09 3/1/09 4/1/09 5/1/09 6/1/09 7/1/09 8/1/09 9/1/09 10/1/09 11/1/09 12/1/09 1/1/10 2/1/10 3/1/10 4/1/10 5/1/10 6/1/10 7/1/10 8/1/10 9/1/10 10/1/10 11/1/10 12/1/10 1/1/11 2/1/11 3/1/11 4/1/11 5/1/11 6/1/11 7/1/11 8/1/11 9/1/11 10/1/11 11/1/11 12/1/11 1/1/12 2/1/12 3/1/12 4/1/12 5/1/12 6/1/12 7/1/12 8/1/12 9/1/12 10/1/12 11/1/12 12/1/12 1/1/13 2/1/13 3/1/13 4/1/13 5/1/13 6/1/13 7/1/13 8/1/13 9/1/13 10/1/13 11/1/13 12/1/13 1/1/14 2/1/14 3/1/14 4/1/14 5/1/14 6/1/14 7/1/14 8/1/14 9/1/14 10/1/14 11/1/14 12/1/14 1/1/15 2/1/15 3/1/15 4/1/15 5/1/15 6/1/15 7/1/15 8/1/15 9/1/15 10/1/15 11/1/15 12/1/15 1/1/16 2/1/16 3/1/16 4/1/16 5/1/16 6/1/16 7/1/16 8/1/16 9/1/16 10/1/16 11/1/16 12/1/16 1/1/17 2/1/17 3/1/17 4/1/17 5/1/17 6/1/17 7/1/17 8/1/17 9/1/17 10/1/17 11/1/17 12/1/17 1/1/18 2/1/18 3/1/18 4/1/18 5/1/18 6/1/18 7/1/18 8/1/18 9/1/18 10/1/18 11/1/18 12/1/18 1/1/19 2/1/19 3/1/19 4/1/19 5/1/19 6/1/19 7/1/19 8/1/19 9/1/19 10/1/19 11/1/19 12/1/19 1/1/20 2/1/20 3/1/20 4/1/20 5/1/20 6/1/20 7/1/20 8/1/20 9/1/20 10/1/20 11/1/20 12/1/20 1/1/21 2/1/21 3/1/21 4/1/21 5/1/21 6/1/21 7/1/21 8/1/21 9/1/21 10/1/21 11/1/21 12/1/21 1/1/22 2/1/22 3/1/22 4/1/22 5/1/22 6/1/22 7/1/22 8/1/22 9/1/22 10/1/22 11/1/22 12/1/22 1/1/23 2/1/23 3/1/23 4/1/23 5/1/23 6/1/23 7/1/23 8/1/23 9/1/23 10/1/23 11/1/23 12/1/23 1/1/24 2/1/24 3/1/24 4/1/24 5/1/24 6/1/24 7/1/24 8/1/24 9/1/24 10/1/24 11/1/24 12/1/24 1/1/25 2/1/25 3/1/25 4/1/25 5/1/25 6/1/25 7/1/25 8/1/25 9/1/25 10/1/25 11/1/25 12/1/25 1/1/26 2/1/26 3/1/26 4/1/26 5/1/26 6/1/26 7/1/26 8/1/26 9/1/26 10/1/26 11/1/26 12/1/26 1/1/27 2/1/27 3/1/27 4/1/27 5/1/27 6/1/27 7/1/27 8/1/27 9/1/27 10/1/27 11/1/27 12/1/27 1/1/28 2/1/28 3/1/28 4/1/28 5/1/28 6/1/28 7/1/28 8/1/28 9/1/28 10/1/28 11/1/28 12/1/28 1/1/29 2/1/29 3/1/29 4/1/29 5/1/29 6/1/29 7/1/29 8/1/29 9/1/29 10/1/29 11/1/29 12/1/29 1/1/30 2/1/30 3/1/30 4/1/30 5/1/30 6/1/30 7/1/30 8/1/30 9/1/30 10/1/30 11/1/30 12/1/30 1/1/31 2/1/31 3/1/31 4/1/31 5/1/31 6/1/31 7/1/31 8/1/31 9/1/31 10/1/31 11/1/31 12/1/31 1/1/32 2/1/32 3/1/32 4/1/32 5/1/32 6/1/32 7/1/32 8/1/32 9/1/32 10/1/32 11/1/32 12/1/32 1/1/33 2/1/33 3/1/33 4/1/33 5/1/33 6/1/33 7/1/33 8/1/33 9/1/33 10/1/33 11/1/33 12/1/33 1/1/34 2/1/34 3/1/34 4/1/34 5/1/34 6/1/34 7/1/34 8/1/34 9/1/34 10/1/34 11/1/34 12/1/34 1/1/35 2/1/35 3/1/35 4/1/35 5/1/35 6/1/35 7/1/35 8/1/35 9/1/35 10/1/35 11/1/35 12/1/35 1/1/36 2/1/36 3/1/36 4/1/36 5/1/36 6/1/36 7/1/36 8/1/36 9/1/36 10/1/36 11/1/36 12/1/36 1/1/37 2/1/37 3/1/37 4/1/37 5/1/37 6/1/37 7/1/37 8/1/37 9/1/37 10/1/37 11/1/37 12/1/37 1/1/38 2/1/38 3/1/38 4/1/38 5/1/38 6/1/38 7/1/38 8/1/38 9/1/38 10/1/38 11/1/38 12/1/38 1/1/39 2/1/39 3/1/39 4/1/39 5/1/39 6/1/39 7/1/39 8/1/39 9/1/39 10/1/39 11/1/39 12/1/39 1/1/40 2/1/40 3/1/40 4/1/40 5/1/40 6/1/40 7/1/40 8/1/40 9/1/40 10/1/40 11/1/40 12/1/40 1/1/41 2/1/41 3/1/41 4/1/41 5/1/41 6/1/41 7/1/41 8/1/41 9/1/41 10/1/41 11/1/41 12/1/41 1/1/42 2/1/42 3/1/42 4/1/42 5/1/42 6/1/42 7/1/42 8/1/42 9/1/42 10/1/42 11/1/42 12/1/42 1/1/43 2/1/43 3/1/43 4/1/43 5/1/43 6/1/43 7/1/43 8/1/43 9/1/43 10/1/43 11/1/43 12/1/43 1/1/44 2/1/44 3/1/44 4/1/44 5/1/44 6/1/44 7/1/44 8/1/44 9/1/44 10/1/44 11/1/44 12/1/44 1/1/45 2/1/45 3/1/45 4/1/45 5/1/45 6/1/45 7/1/45 8/1/45 9/1/45 10/1/45 11/1/45 12/1/45 1/1/46 2/1/46 3/1/46 4/1/46 5/1/46 6/1/46 7/1/46 8/1/46 9/1/46 10/1/46 11/1/46 12/1/46 1/1/47 2/1/47 3/1/47 4/1/47 5/1/47 6/1/47 7/1/47 8/1/47 9/1/47 10/1/47 11/1/47 12/1/47 1/1/48 2/1/48 3/1/48 4/1/48 5/1/48 6/1/48 7/1/48 8/1/48 9/1/48 10/1/48 11/1/48 12/1/48 1/1/49 2/1/49 3/1/49 4/1/49 5/1/49 6/1/49 7/1/49 8/1/49 9/1/49 10/1/49 11/1/49 12/1/49 1/1/50 2/1/50 3/1/50 4/1/50 5/1/50 6/1/50 7/1/50 8/1/50 9/1/50 10/1/50 11/1/50 12/1/50 1/1/51 2/1/51 3/1/51 4/1/51 5/1/51 6/1/51 7/1/51 8/1/51 9/1/51 10/1/51 11/1/51 12/1/51 1/1/52 2/1/52 3/1/52 4/1/52 5/1/52 6/1/52 7/1/52 8/1/52 9/1/52 10/1/52 11/1/52 12/1/52 1/1/53 2/1/53 3/1/53 4/1/53 5/1/53 6/1/53 7/1/53 8/1/53 9/1/53 10/1/53 11/1/53 12/1/53 1/1/54 2/1/54 3/1/54 4/1/54 5/1/54 6/1/54 7/1/54 8/1/54 9/1/54 10/1/54 11/1/54 12/1/54 1/1/55 2/1/55 3/1/55 4/1/55 5/1/55 6/1/55 7/1/55 8/1/55 9/1/55 10/1/55 11/1/55 12/1/55 1/1/56 2/1/56 3/1/56 4/1/56 5/1/56 6/1/56 7/1/56 8/1/56 9/1/56 10/1/56 11/1/56 12/1/56 1/1/57 2/1/57 3/1/57 4/1/57 5/1/57 6/1/57 7/1/57 8/1/57 9/1/57 10/1/57 11/1/57 12/1/57 1/1/58 2/1/58 3/1/58 4/1/58 5/1/58 6/1/58 7/1/58 8/1/58 9/1/58 10/1/58 11/1/58 12/1/58 1/1/59 2/1/59 3/1/59 4/1/59 5/1/59 6/1/59 7/1/59 8/1/59 9/1/59 10/1/59 11/1/59 12/1/59 1/1/60 2/1/60 3/1/60 4/1/60 5/1/60 6/1/60 7/1/60 8/1/60 9/1/60 10/1/60 11/1/60 12/1/60 1/1/61 2/1/61 3/1/61 4/1/61 5/1/61 6/1/61 7/1/61 8/1/61 9/1/61 10/1/61 11/1/61 12/1/61 1/1/62 2/1/62 3/1/62 4/1/62 5/1/62 6/1/62 7/1/62 8/1/62 9/1/62 10/1/62 11/1/62 12/1/62 1/1/63 2/1/63 3/1/63 4/1/63 5/1/63 6/1/63 7/1/63 8/1/63 9/1/63 10/1/63 11/1/63 12/1/63 1/1/64 2/1/64 3/1/64 4/1/64 5/1/64 6/1/64 7/1/64 8/1/64 9/1/64 10/1/64 11/1/64 12/1/64 1/1/65 2/1/65 3/1/65 4/1/65 5/1/65 6/1/65 7/1/65 8/1/65 9/1/65 10/1/65 11/1/65 12/1/65 1/1/66 2/1/66 3/1/66 4/1/66 5/1/66 6/1/66 7/1/66 8/1/66 9/1/66 10/1/66 11/1/66 12/1/66 1/1/67 2/1/67 3/1/67 4/1/67 5/1/67 6/1/67 7/1/67 8/1/67	