FOTO-FAX 250 12-83 7511F

HILLCREST DRIVE 70 FT. WD. PLAN

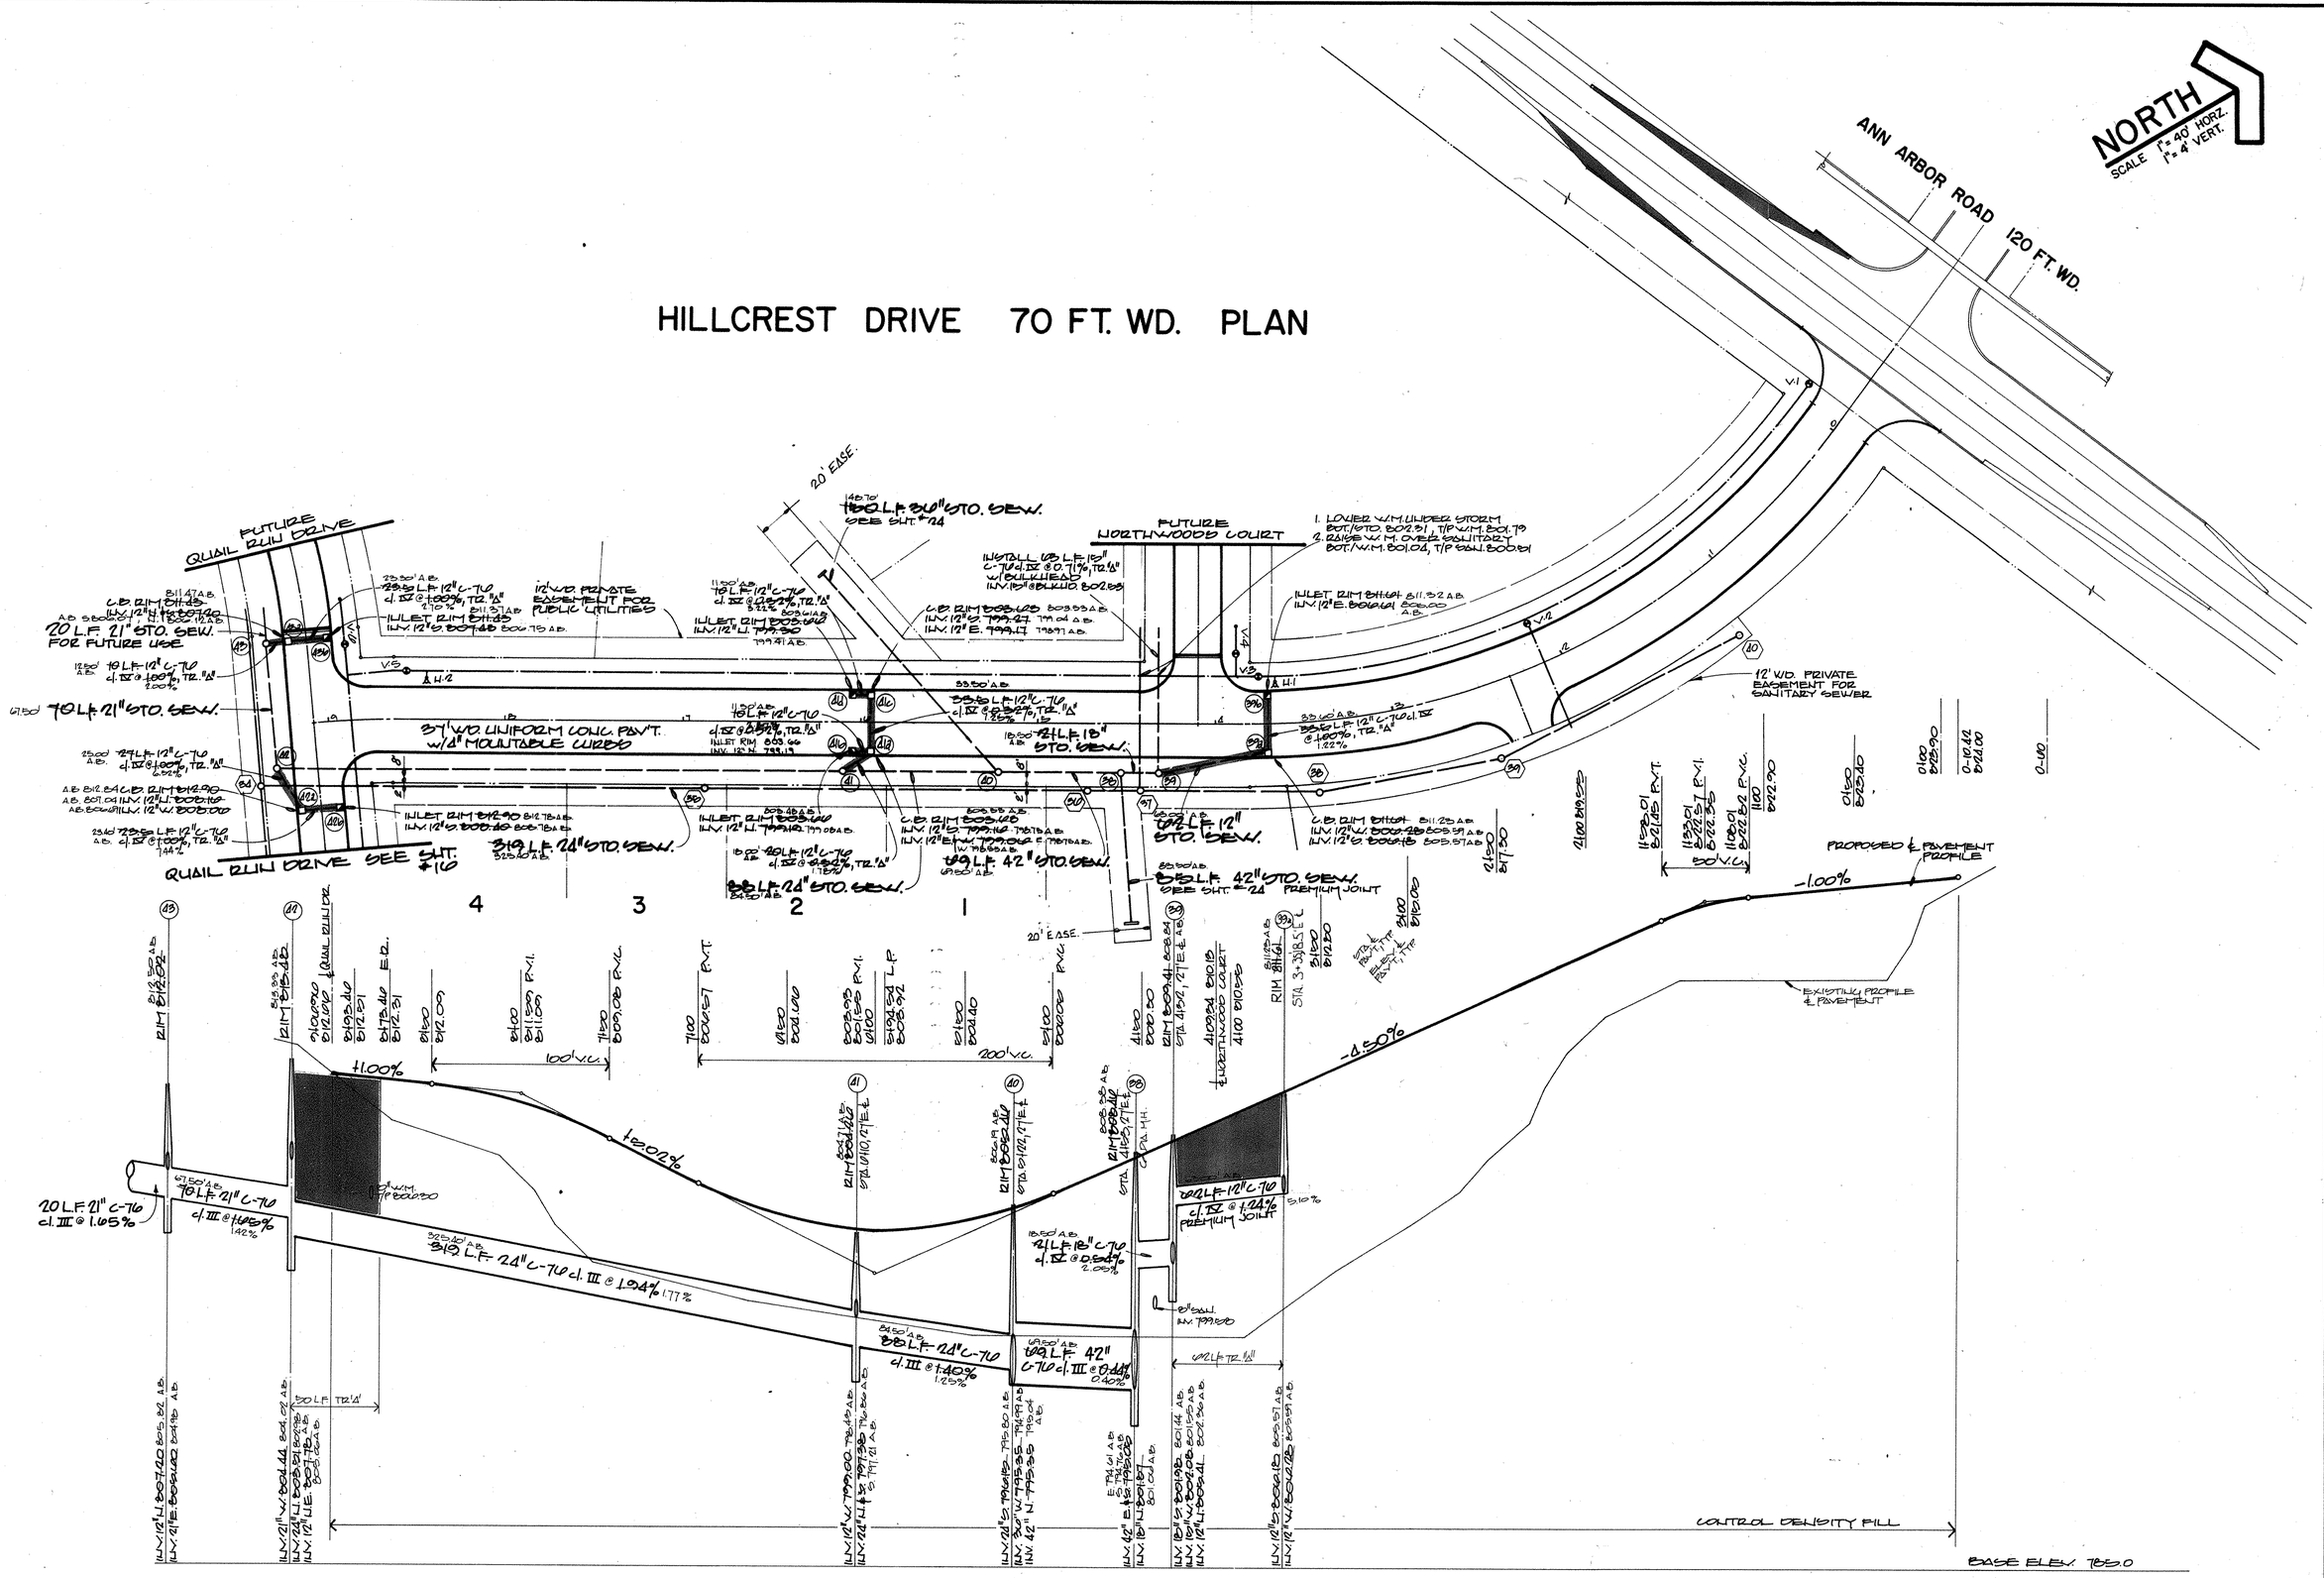

NOTE: The as-built sections of these plans bear the designation "A.B." for as-built.

NORTH HILLCREST DRIVE

JMS Jarrett - Mills - Schron and associates, inc.
CONSULTING ENGINEERS & SURVEYORS
P.O. Box 466, 35122 Michigan Ave., Wayne, Michigan 48184
(313) 722-5530

QUAIL RUN SUBDIVISION
PART OF THE S.W. 1/4 SEC. 32, T.1S., R.9E.,
PLYMOUTH TWP., WAYNE CO., MICHIGAN

STORM SEWER PLAN & PROFILE

SHEET NO.	JOB NO.	DRAWING NO.	DATE	REVISIONS
15	800420	A-447	9-26-80	5-8-81 As-built 2-8-83 As-built 7-10-83 As-built

DRAWN BY: WACZASTOWSKI
CHECKED BY: J.R. JAROZEWT