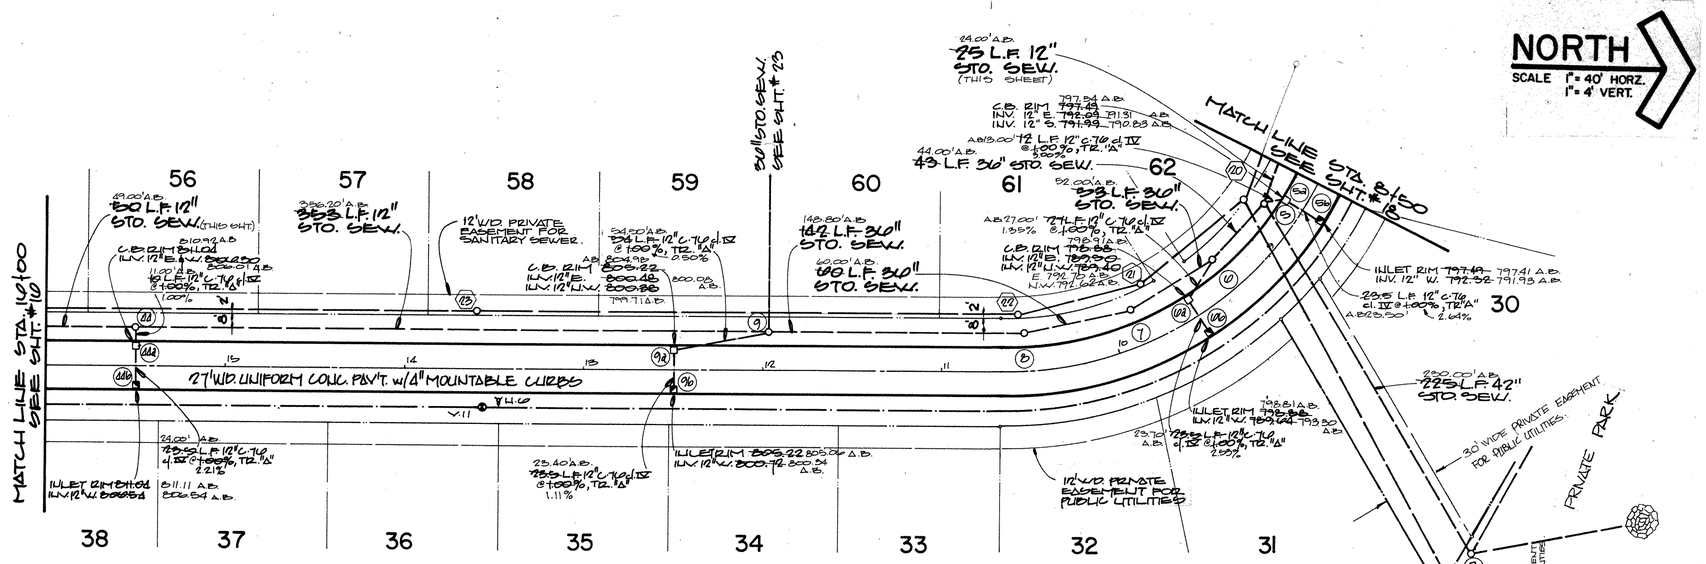

QUAIL CIRCLE 60 FT. WD. PLAN

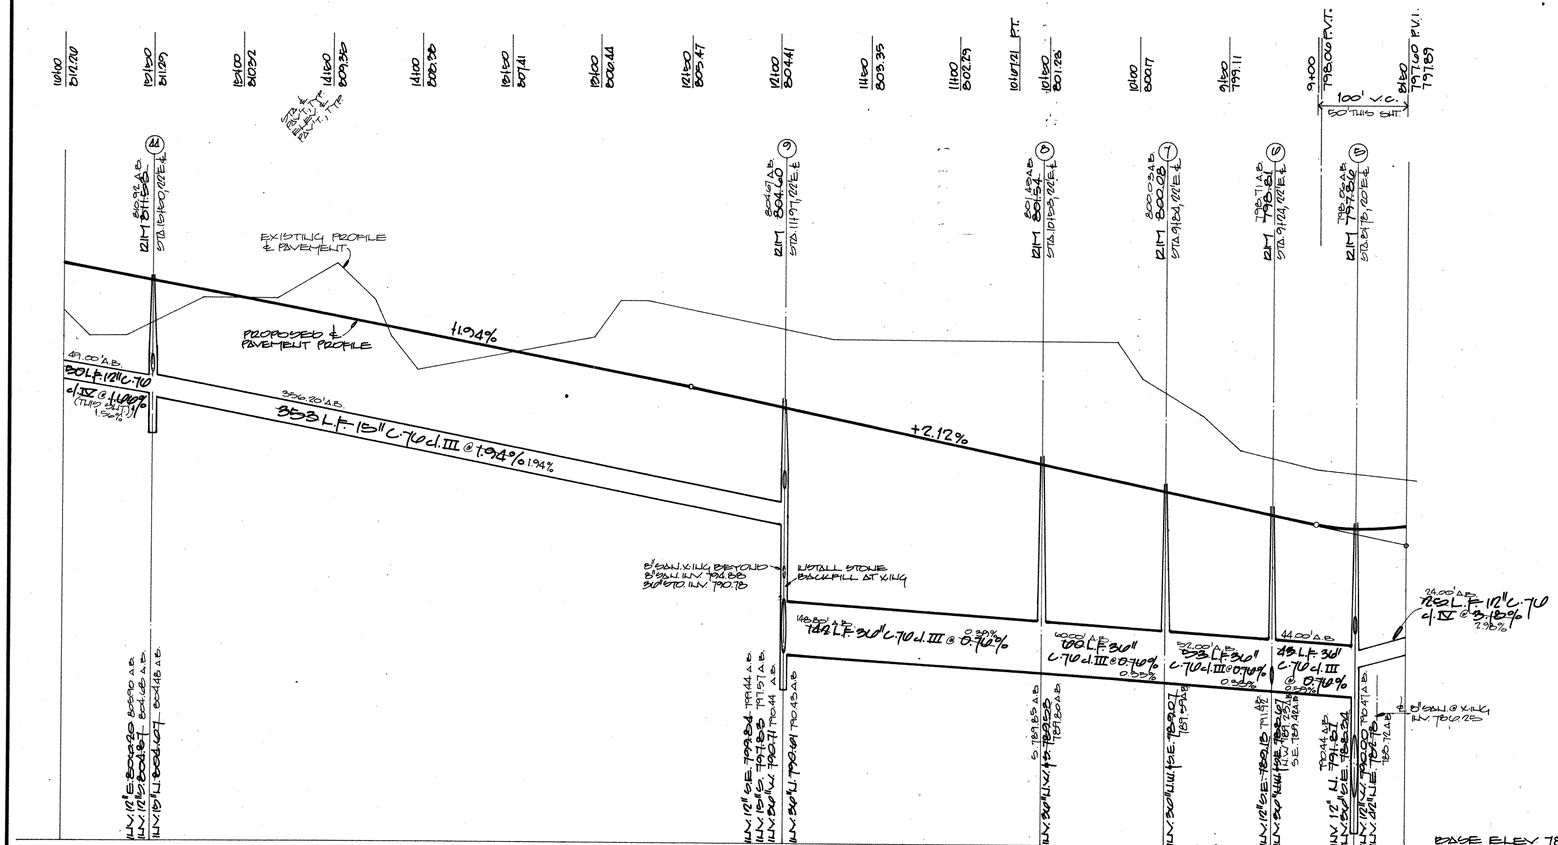

PROFILE
QUAIL CIRCLE

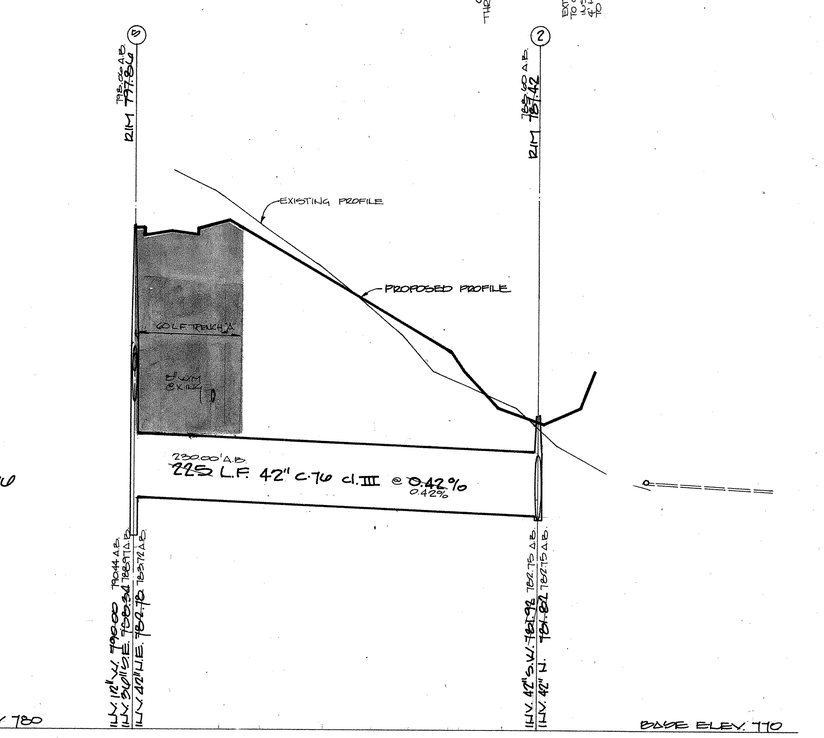

PROFILE
QUAIL CIRCLE

NOTE: The as-built sections of these plans bear the designation "A.B." for as-built.

JMS Jarrett - Mills - Schron and associates, inc.
CONSULTING ENGINEERS and LAND SURVEYORS
P.O. Box 1062, 21622 Grand River Avenue • Detroit, Michigan 48224
(313) 722-5550

STORM SEWER PLAN & PROFILE

QUAIL RUN SUBDIVISION
PART OF THE S.W. 1/4 SEC. 32, T.1S., R.9E., PLYMOUTH TWP., WAYNE CO., MICHIGAN

REVISIONS	DATE	DRAWING NO.	JOB NO.	SHEET NO.
5-5-87 5-6-87 2-18-88 3-9-88 7-25-88 3-9-89 7-20-89	9-25-80	A-401	80004120	19
	DRAWN BY J.R. BLACKFORD	CHECKED BY J.R. JUZZETTI		